



SHEET NOTES

1. LOAD CENTERS PROVIDED BY RELO MANUFACTURER.
2. PROVIDE CONNECTION TO LOAD CENTERS AS SHOWN ON SITE PLANS.
3. ALL EQUIPMENT IS NEW UNLESS NOTED OTHERWISE.

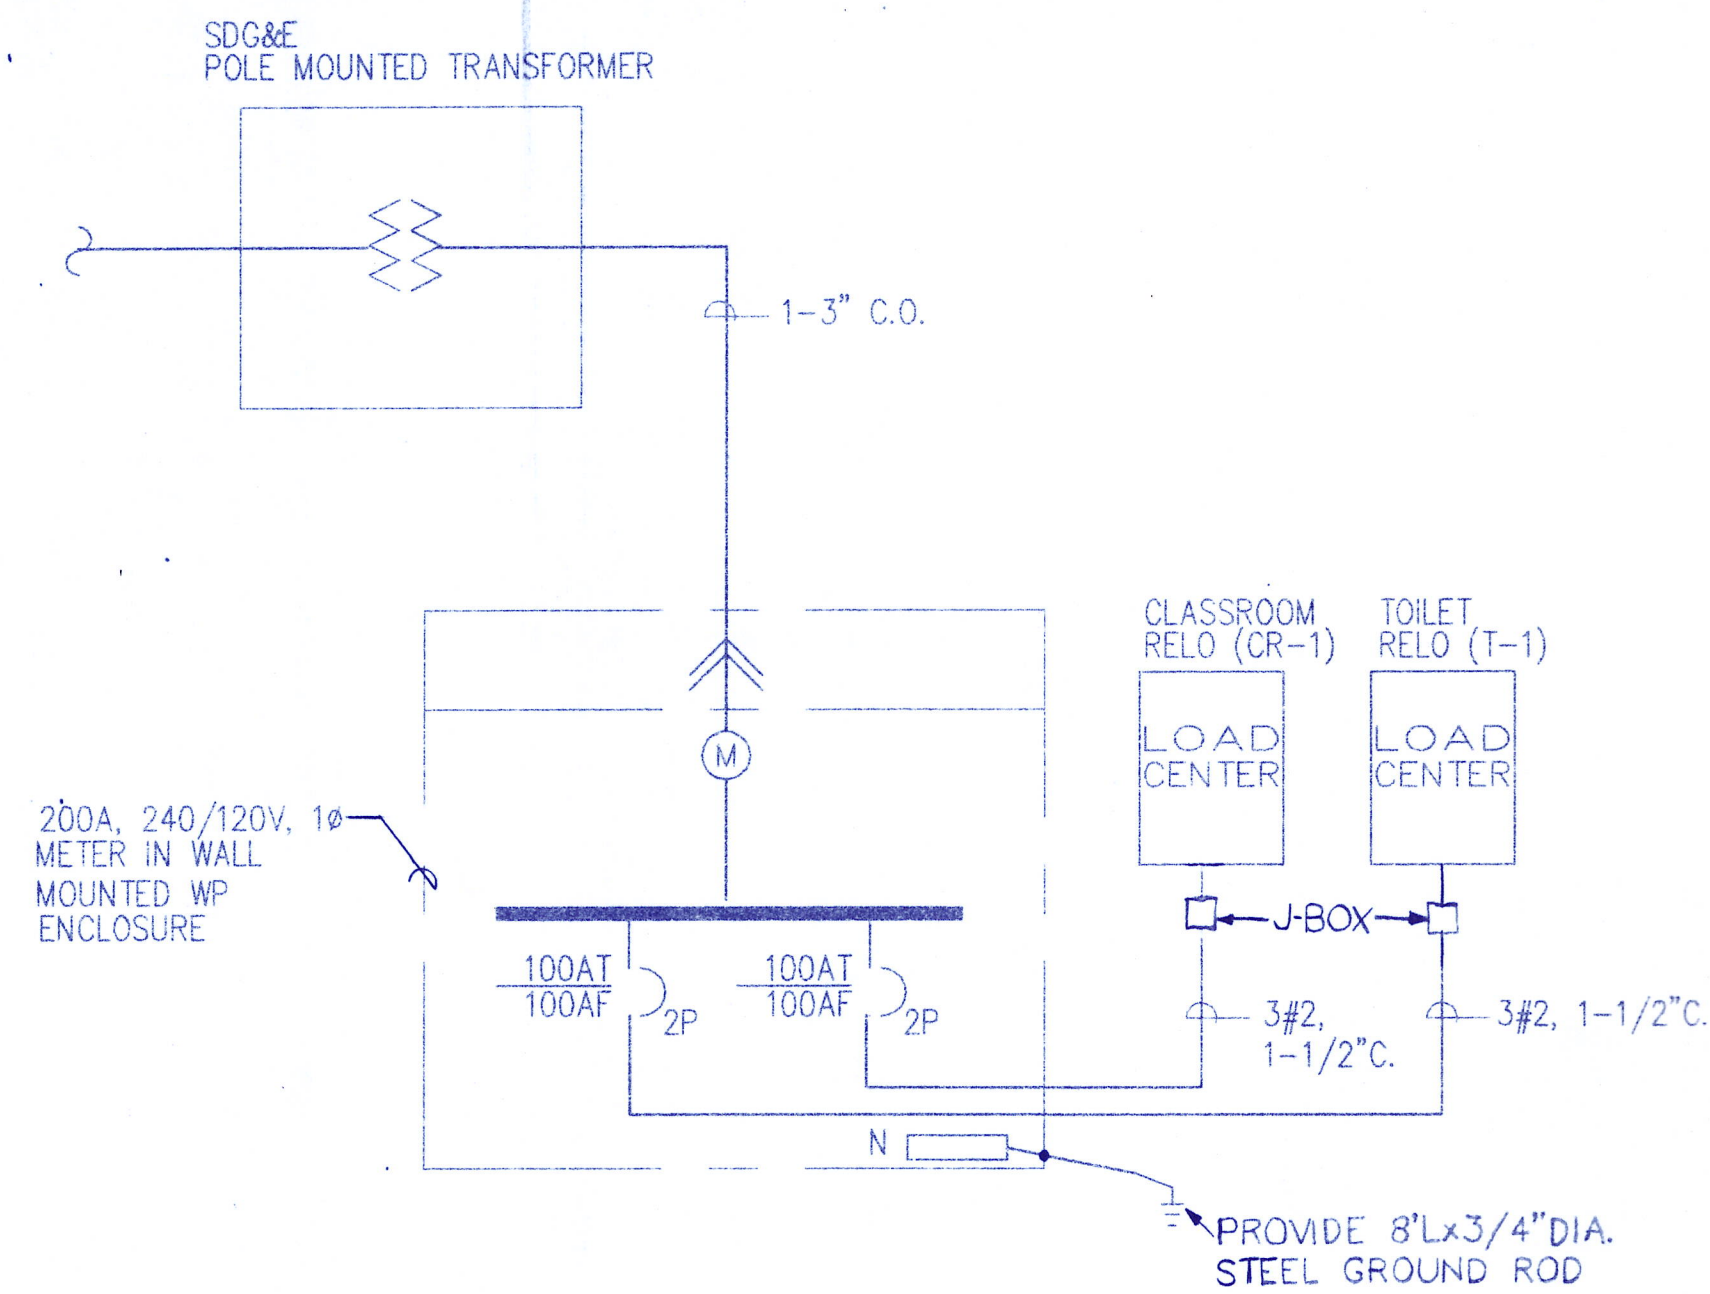


MT. EMPIRE ALT. ED.
SINGLE-LINE DIAGRAM
SCALE: NONE

1

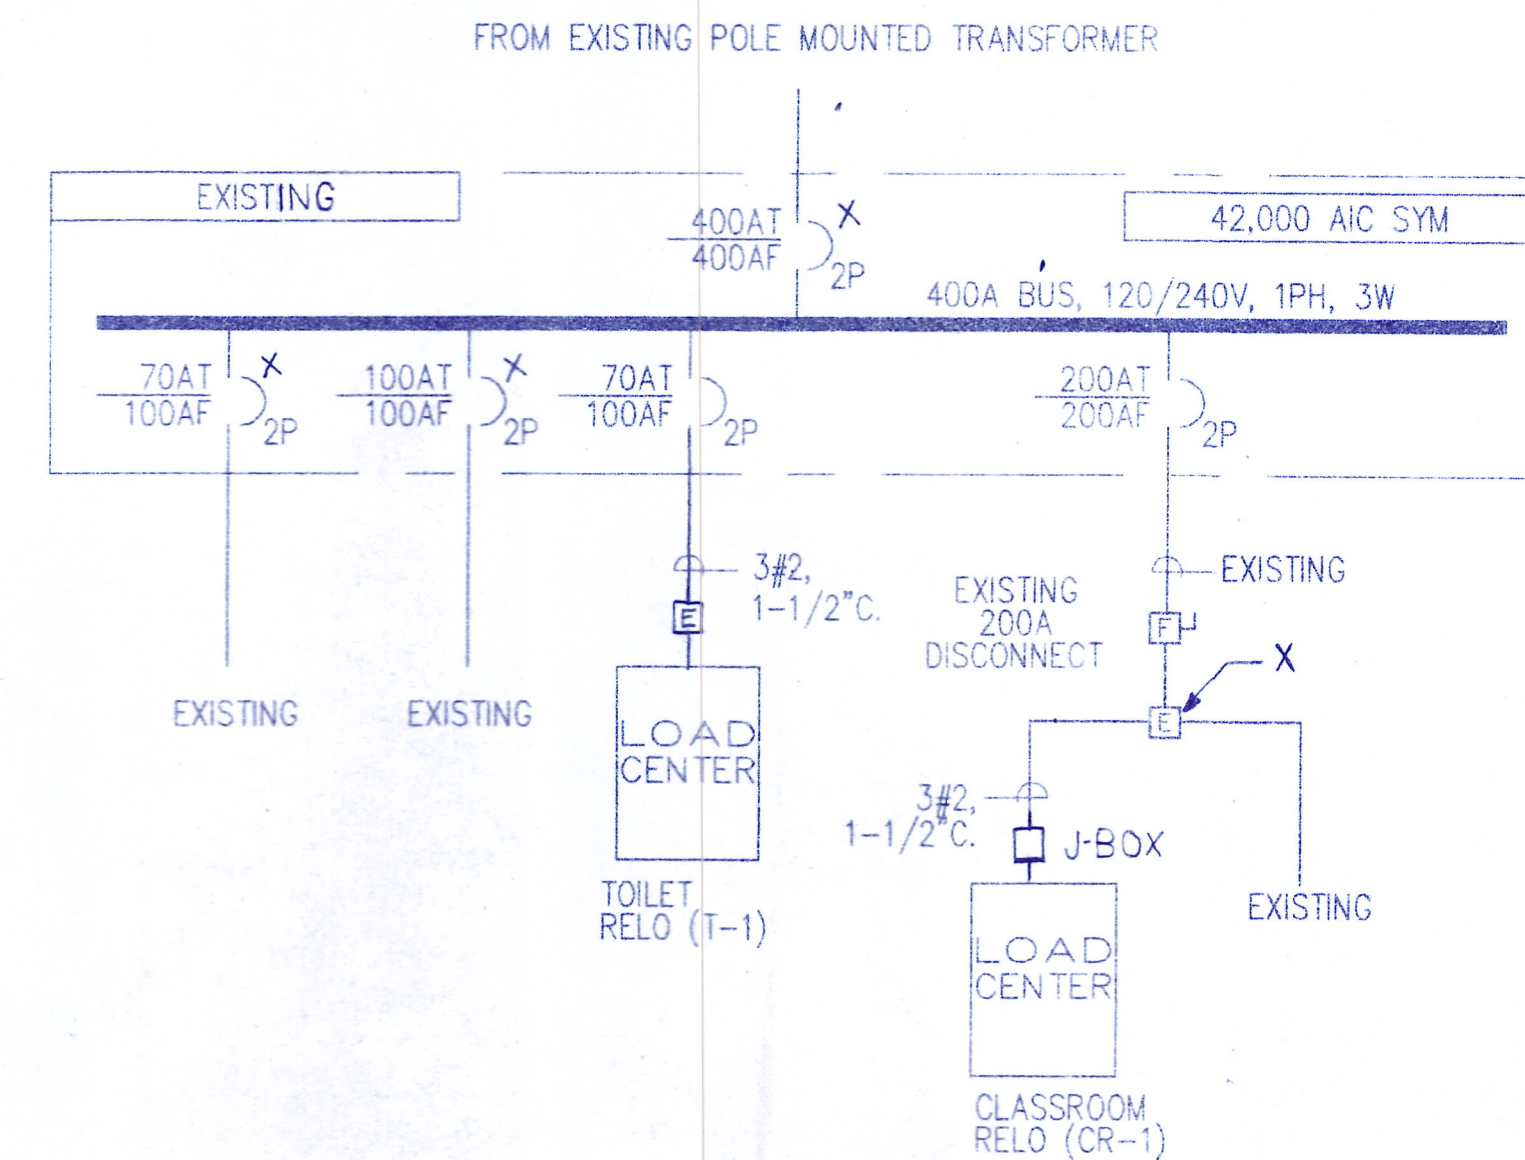


CLOVER FLAT
SINGLE-LINE DIAGRAM
SCALE: NONE

2

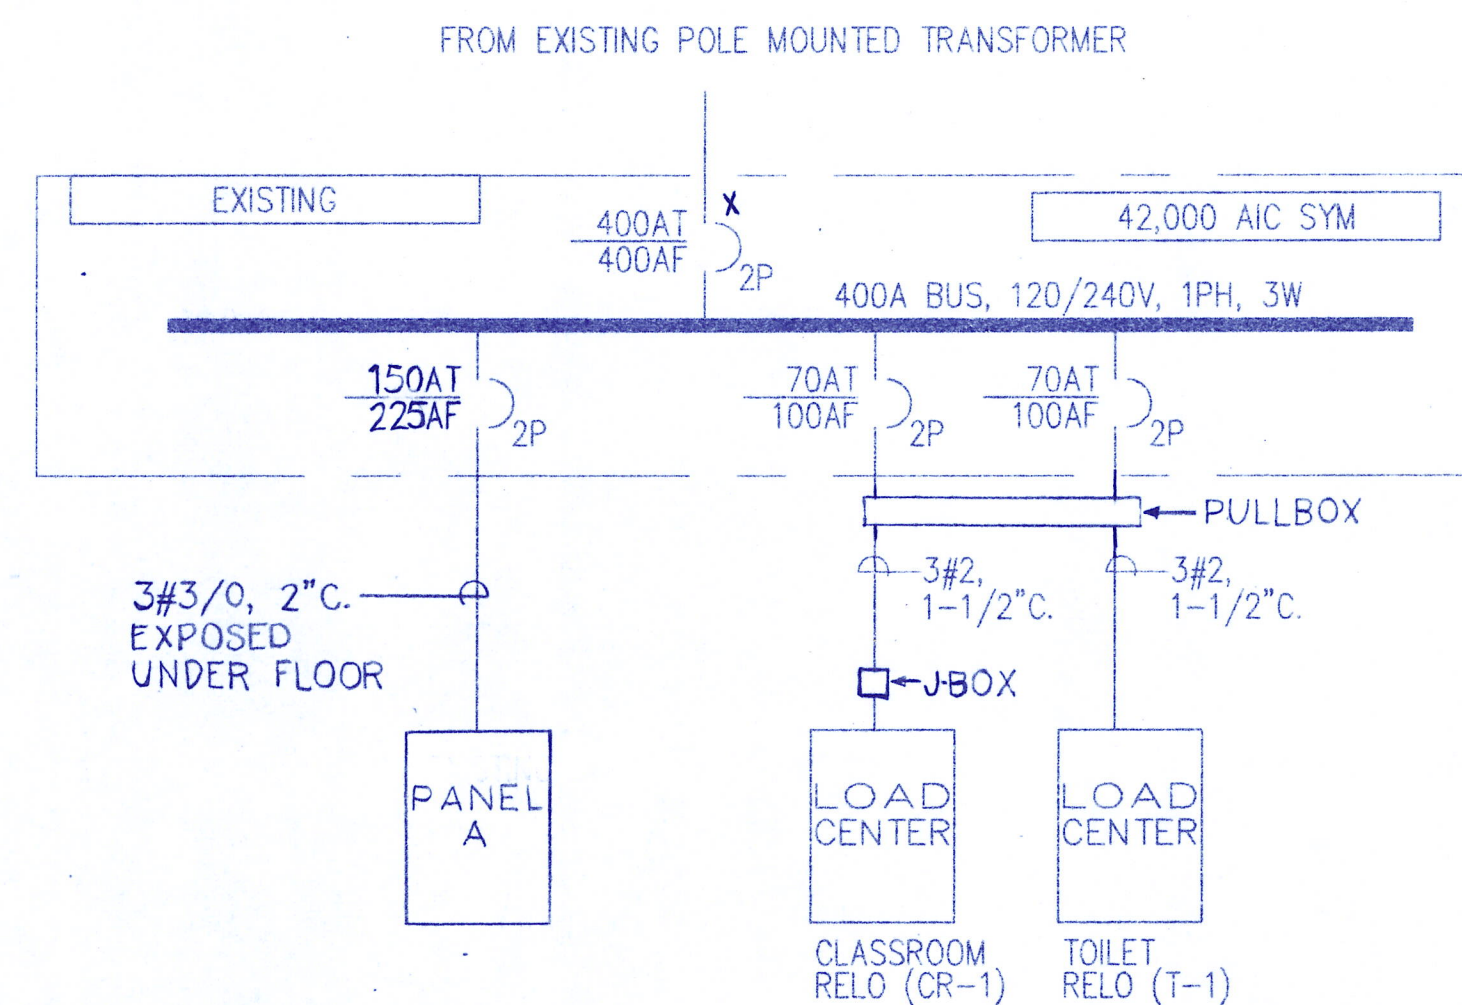


JACUMBA
SINGLE-LINE DIAGRAM
SCALE: NONE

3

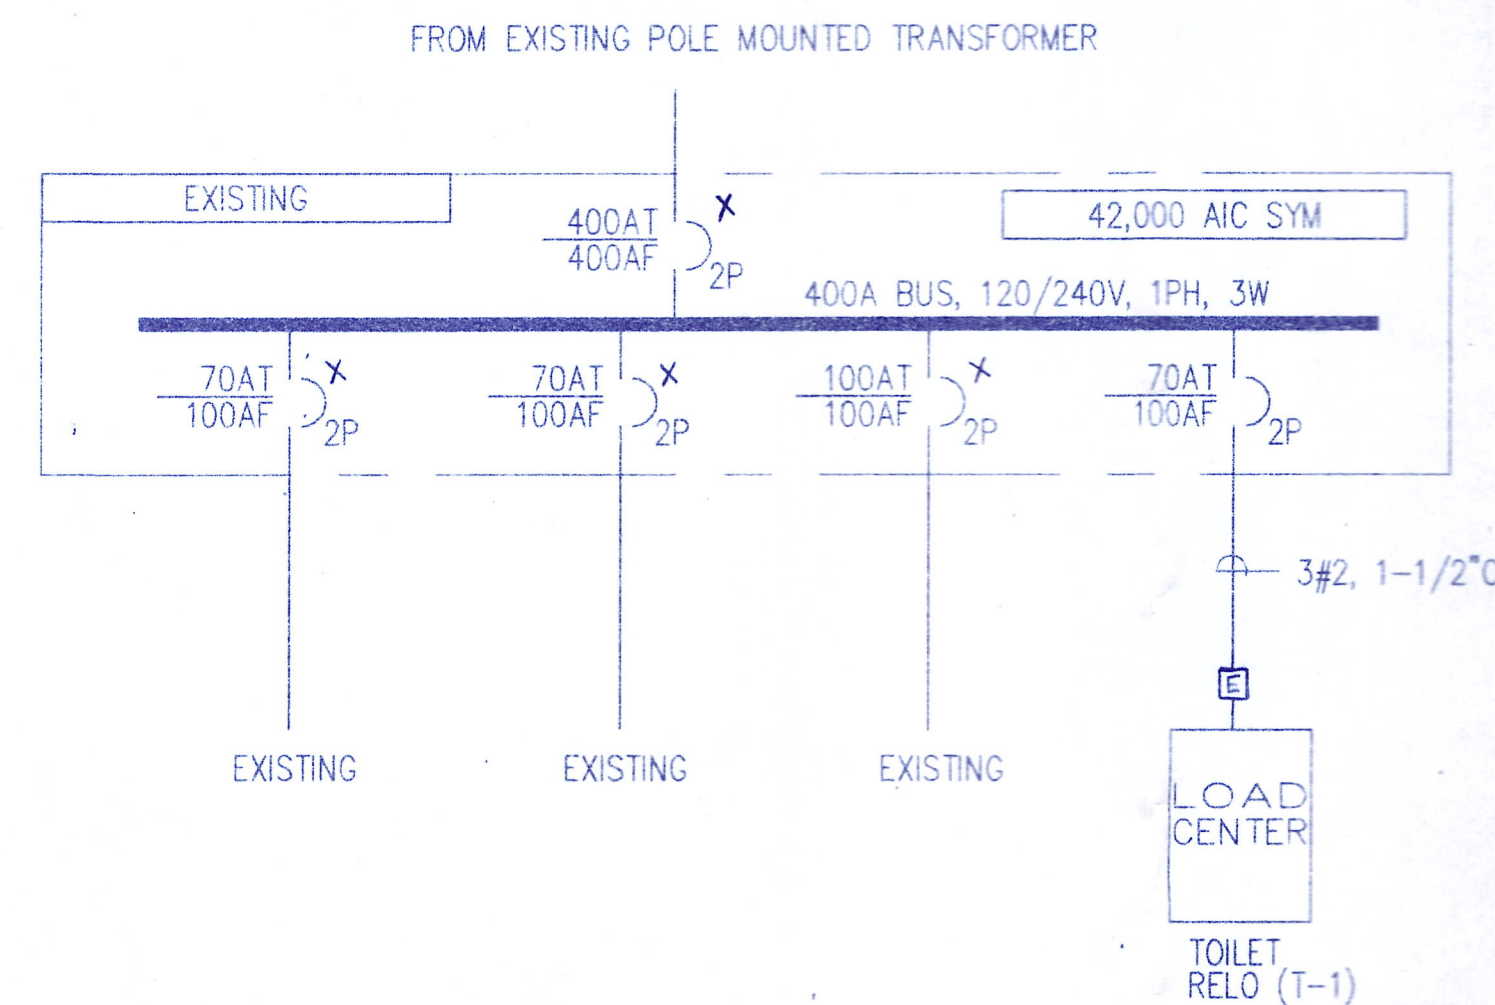

DESCANSO
SINGLE-LINE DIAGRAM
SCALE: NONE

4

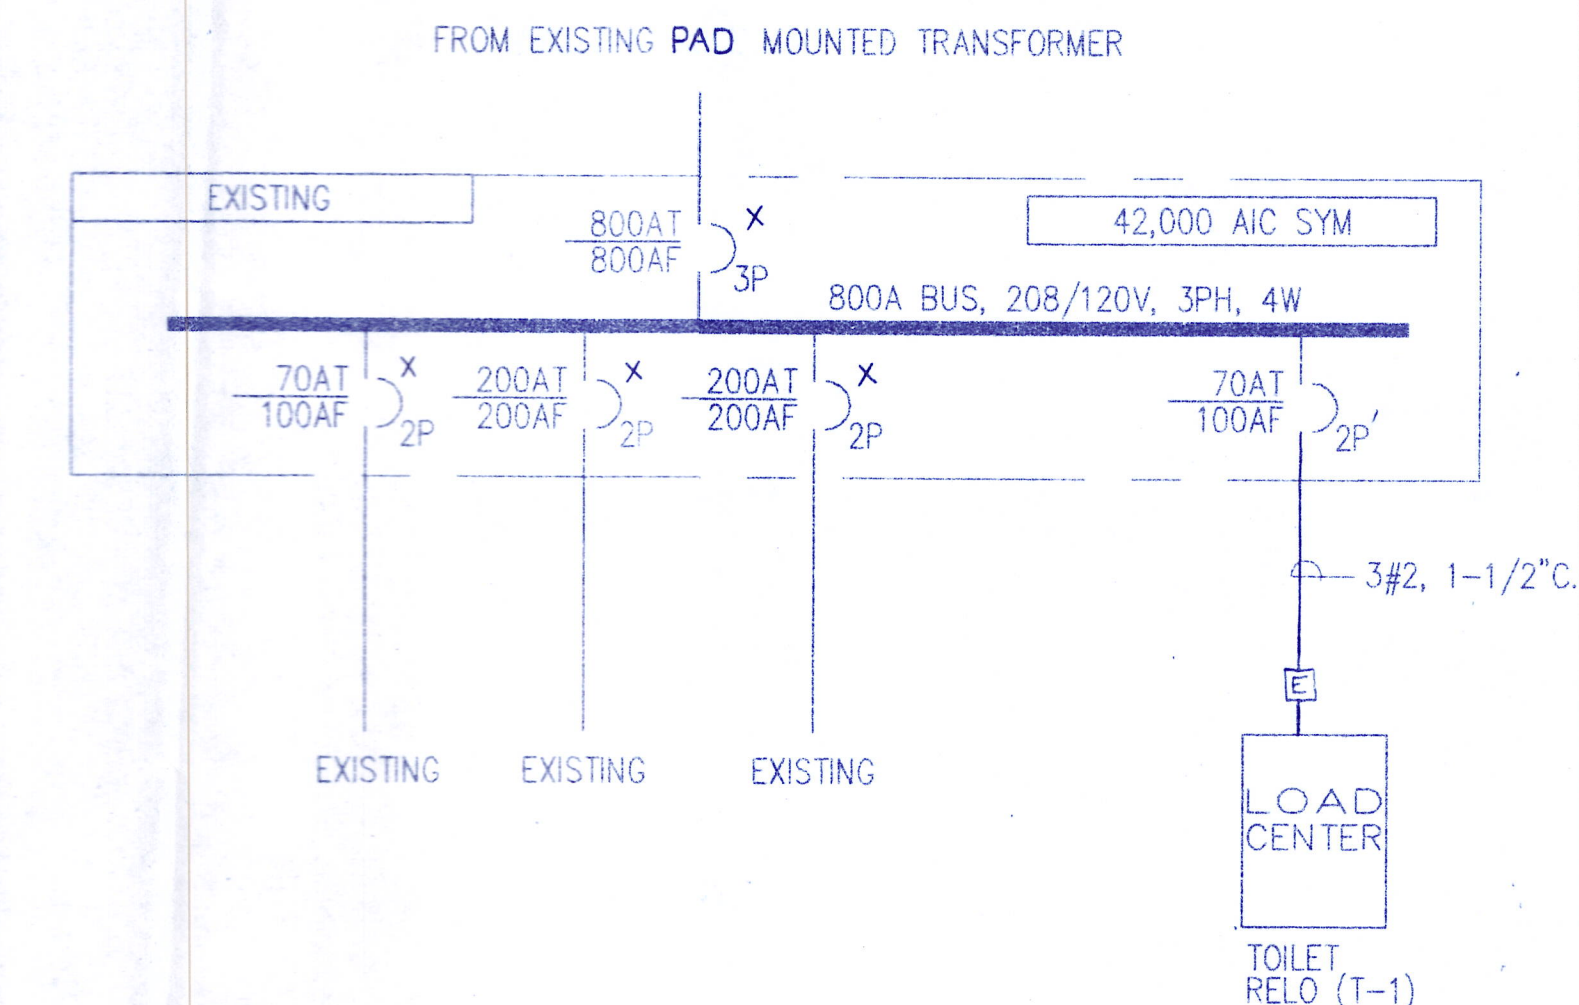

POTRERO
SINGLE-LINE DIAGRAM
SCALE: NONE

5



STATE APPROVALS

LAMB CONSULTING ENGINEERS

2445 5th Avenue
Suite 310
San Diego CA 92101
Phone: 619.235.6620
Fax: 619.235.9401
lambengr@adnc.com

